


SIENA SQUARE

Keys Commercial

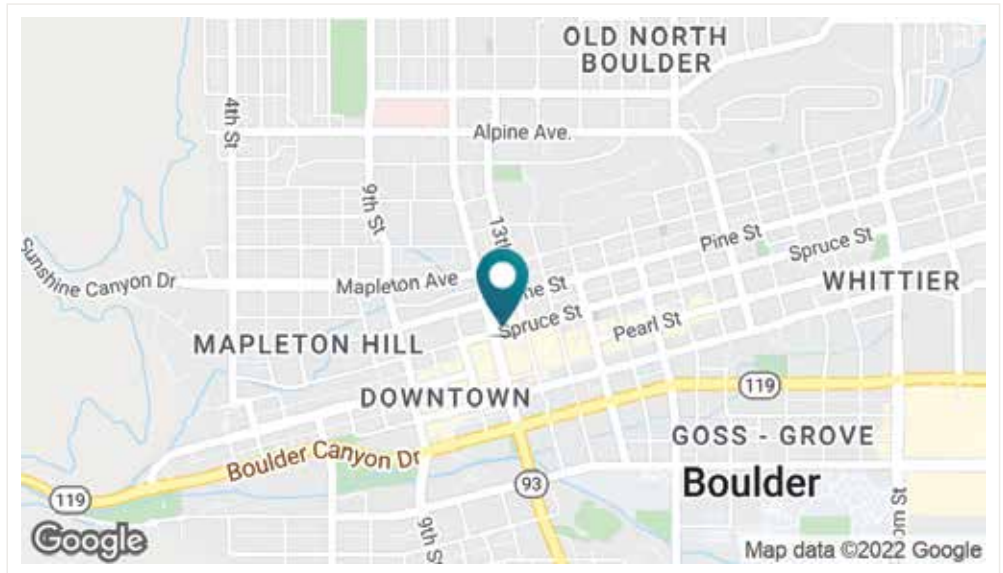

OFFERING SUMMARY

Lease Rate:	\$21.00 SF/yr (NNN)
NNN Expenses:	\$19.00 SF/yr
Building Size:	54,224 SF
Available SF:	700 - 2,782 SF
Year Built:	1891
Renovated:	2020
Zoning:	DT-4

GEOFFREY E. KEYS

303.214.1540

keys@keys-commercial.co

PROPERTY OVERVIEW

Prominently located and highly visible office & retail building located at the southeast corner of Spruce & Broadway in Downtown Boulder. The property is in close proximity to and directly visible from a City of Boulder surface parking lot and a City of Boulder parking garage and advantageously positioned between these parking options and the iconic Boulderado Hotel to the north and the Pearl Street Pedestrian Mall and St. Julien Hotel to the south. The property was beautifully renovated in 2020!

Siena Square features a variety of available office suites ranging in size and layout. These available spaces are in good condition and can be taken immediately as-is or improved to meet any requirement. The building features common showers, bike storage, and seating throughout its stunning five-story atrium.

PROPERTY HIGHLIGHTS

Prominent downtown location with high visibility to foot & vehicle traffic.

Located in 'CAGID' district. Tenants are eligible for free RTD Eco-passes and visitor parking validation program.

2020 renovations throughout the property just completed!

In immediate proximity to multiple parking options. City garage parking permits available to tenants.

FOR LEASE | OFFICE | RETAIL

SIENA SQUARE

Keys Commercial



GEOFFREY E. KEYS

303.214.1540


keys@keys-commercial.co

FOR LEASE | OFFICE | RETAIL

SIENA SQUARE

SUITE 280 (1,326 RSF)

Keys Commercial

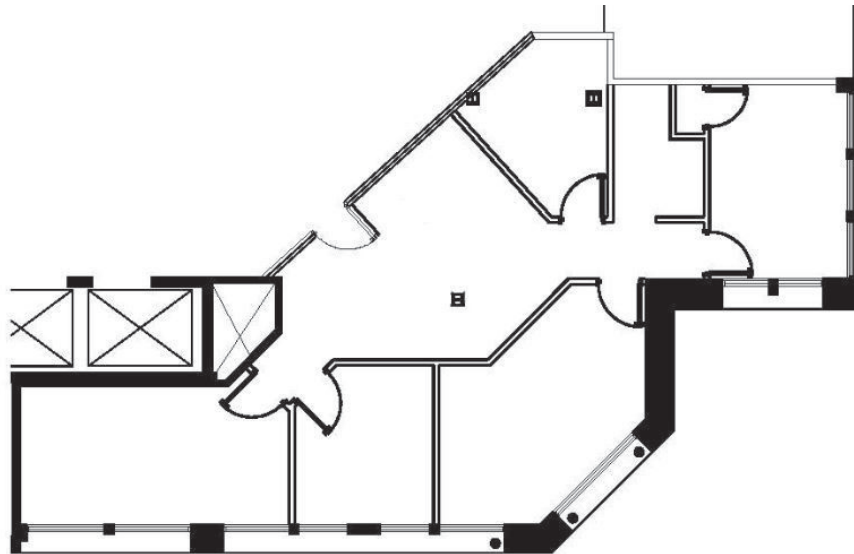

GEOFFREY E. KEYS

303.214.1540


keys@keys-commercial.co

FOR LEASE | OFFICE | RETAIL

SIENA SQUARE

SUITE 200 (2,782 RSF)

Keys Commercial

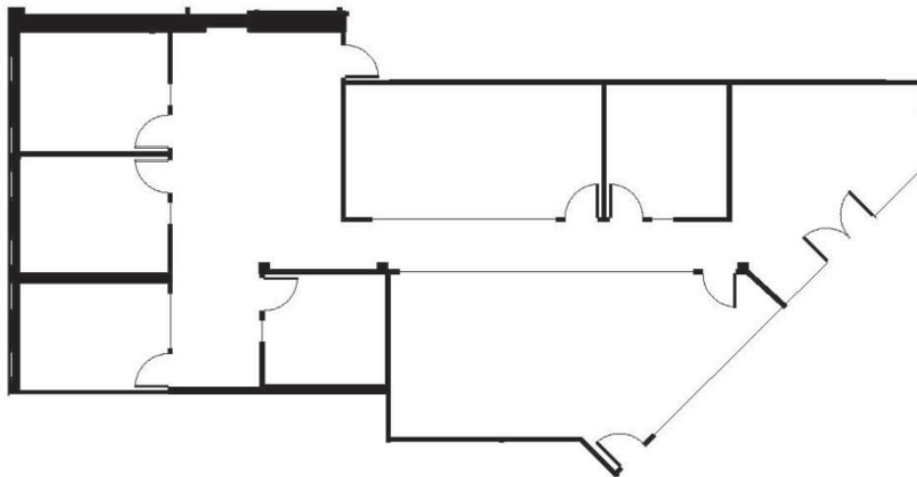

GEOFFREY E. KEYS

303.214.1540


keys@keys-commercial.co

As-Built Floor Plan

SIENA SQUARE

SUITE 380 (1,356 RSF)

Keys Commercial

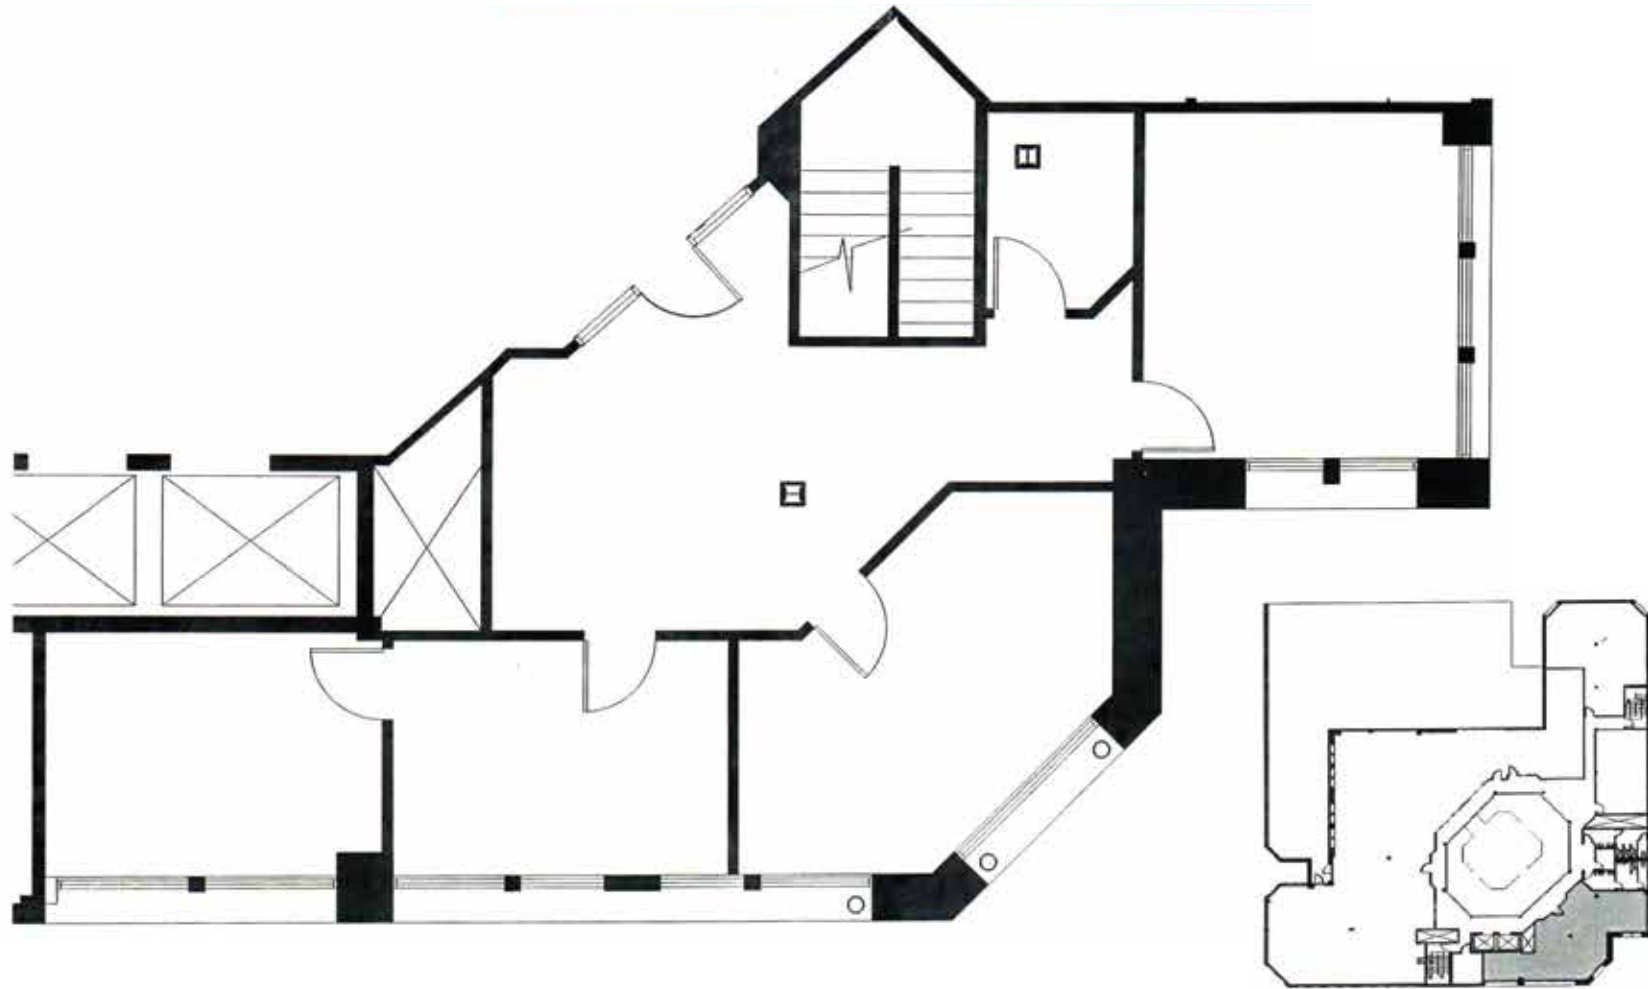

GEOFFREY E. KEYS

303.214.1540

keys@keys-commercial.co


Proximity Plan

As-Built Floor Plan

SIENA SQUARE

(770 RSF)

Keys Commercial

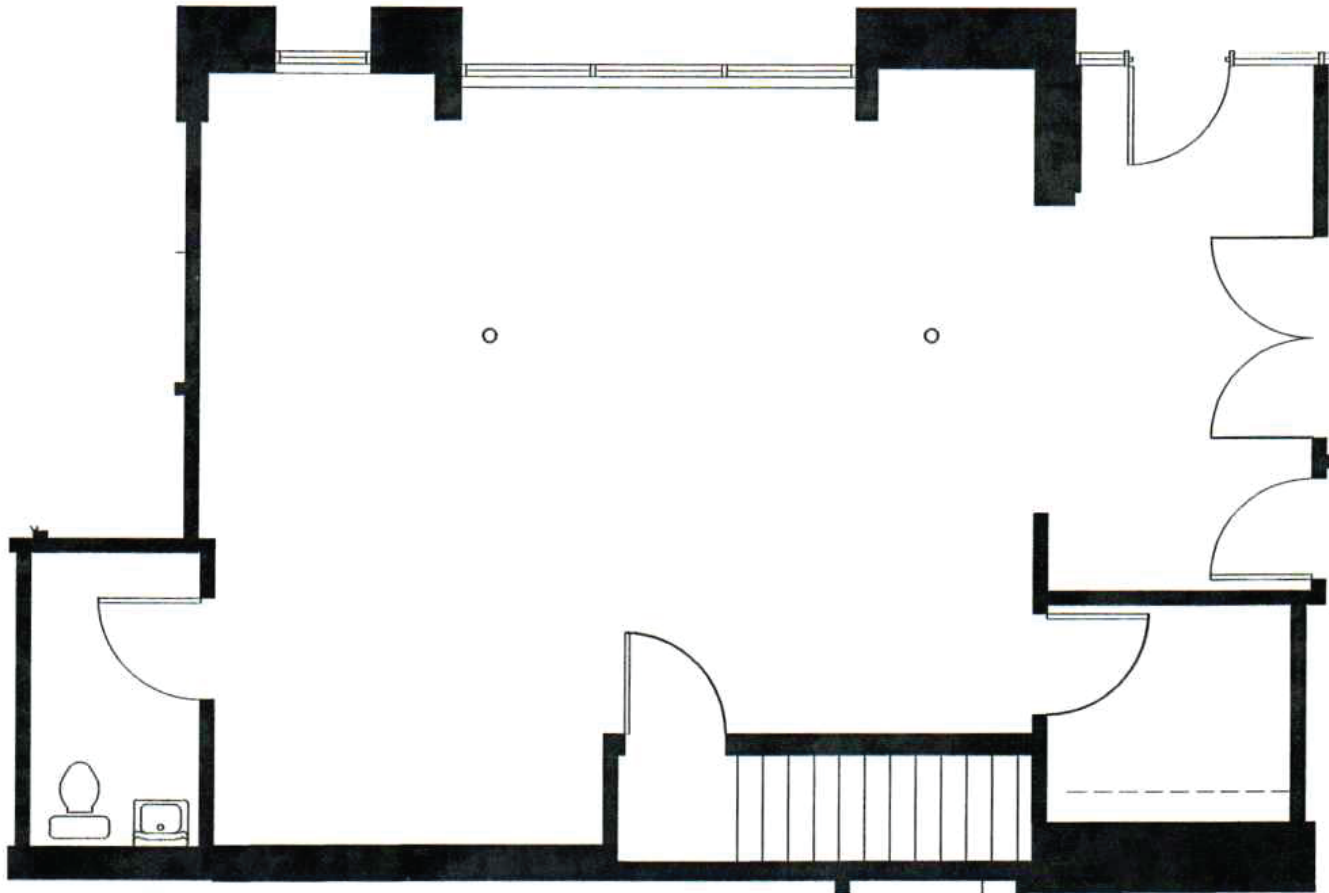

Proximity Plan

GEOFFREY E. KEYS

303.214.1540

keys@keys-commercial.co